



RECORD DRAWING NOTE


THESE RECORD DRAWINGS HAVE BEEN COMPILED BY DAVID EVANS AND ASSOCIATES, INC. (DEA) BASED ON FIELD CHANGES, INFORMATION INCLUDED IN CONSTRUCTION CHANGE ORDERS, AND SURVEY INFORMATION. THE LINED OUT PORTIONS OF THESE DRAWINGS REPRESENT CHANGES TO THE APPROVED PLANS. THESE DRAWINGS DO NOT REPRESENT A SURVEY OF ALL PROJECT IMPROVEMENTS INCLUDED IN THE CONTRACT PLANS.

THESE RECORD DRAWINGS ACCURATELY REFLECT FIELD CONDITIONS AS OF THIS DATE: 1/23/14

CITY OF FIFE


70TH AVENUE EAST - PHASE 2

PORTIONS OF SECTIONS 7 and 8, T.20N, R.4E. W.M.
CITY OF FIFE, PIERCE COUNTY, WASHINGTON

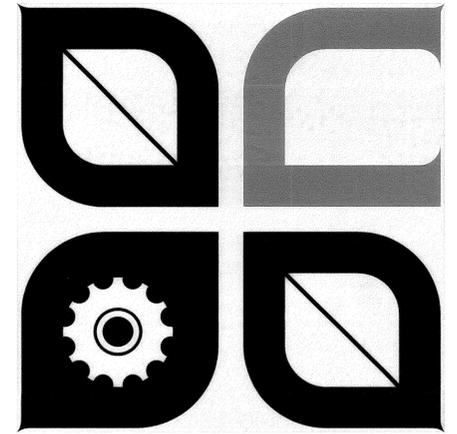

PROJECT OWNER:
CITY OF FIFE

PLAN SHEET INDEX		
SHEET NUMBER	PLAN REFERENCE NUMBER	DESCRIPTION
1	G-1	COVER SHEET
2	G-2	LEGEND AND ABBREVIATIONS
3	SV-1	HORIZONTAL AND VERTICAL CONTROL
4	SQ-1	SUMMARY OF QUANTITIES
5	CA-1	CLASS A SIGN AND FUNDING SIGN PLAN
6	CS-1	CONTRACTOR STAGING AREA AND GRADING PLAN
7-14	EC-1 TO EC-8	T.E.S.C. PLANS
15-29	SP-1 TO SP-15	SITE PREPARATION PLANS
30-38	RS-1 TO RS-9	ROADWAY CROSS SECTIONS
39	XS-1	TYPICAL ROADWAY SECTION 'A' AND BID ALTERNATE
40-44	XS-2 TO XS-6	TYPICAL ROADWAY SECTIONS 'B' THRU 'G'
45-47	DT-1 TO DT-3	ROADWAY DETAILS
48-64	PP-1 TO PP-17	ROADWAY PLAN AND PROFILES
65-66	PP-18 TO PP-19	SHARED USE PATH AND PARKING PLAN AND DETAILS
67-69	CR-1 TO CR-3	CURB RETURN AND CURB RAMP DATA
70-71	DW-1 TO DW-2	DRIVEWAY PROFILES
72-74	WL-1 TO WL-3	WALL PROFILES AND DETAILS
75-78	SN-1 TO SN-4	STORM DRAINAGE STRUCTURE NOTES
79-111	SD-1 TO SD-33	STORM DRAINAGE PLAN, PROFILES AND DETAILS
112	SD-34	STORM WATER PUMP STATION RELOCATION PLAN
113-114	UC-1 TO UC-2	UTILITY CROSSINGS DATA
115-117	PS-1 TO PS-3	POND 'A' PUMP STATION PLAN AND DETAILS
118-120	EL-1 TO EL-3	POND 'A' PUMP STATION ELECTRICAL PLANS
121	SS-1	GRAVITY SANITARY SEWER EXTENSION AND SANITARY SEWER CONNECTION PARCEL #0420074008
122	SS-2	MANHOLE RELOCATION AND SSFM CONNECTION PLAN
123	SS-3	SANITARY SEWER PLAN AND DETAILS
124-133	WA-1 TO WA-10	WATER PLANS AND DETAILS
134-139	SG-1 TO SG-6	TRAFFIC SIGNAL PLANS
140-147	IL-1 TO IL-8	ILLUMINATION PLANS AND DETAILS
148-165	CH-1 TO CH-18	CHANNELIZATION AND PERMANENT SIGNING PLANS
166-172	LA-1 TO LA-7	LANDSCAPE PLANS AND DETAILS
173-179	IR-1 TO IR-7	IRRIGATION PLANS AND DETAILS
180-192	UT-1 TO UT-13	FRANCHISE UTILITY PLANS
		TPU UTILITY PLANS
		PSE UTILITY PLANS

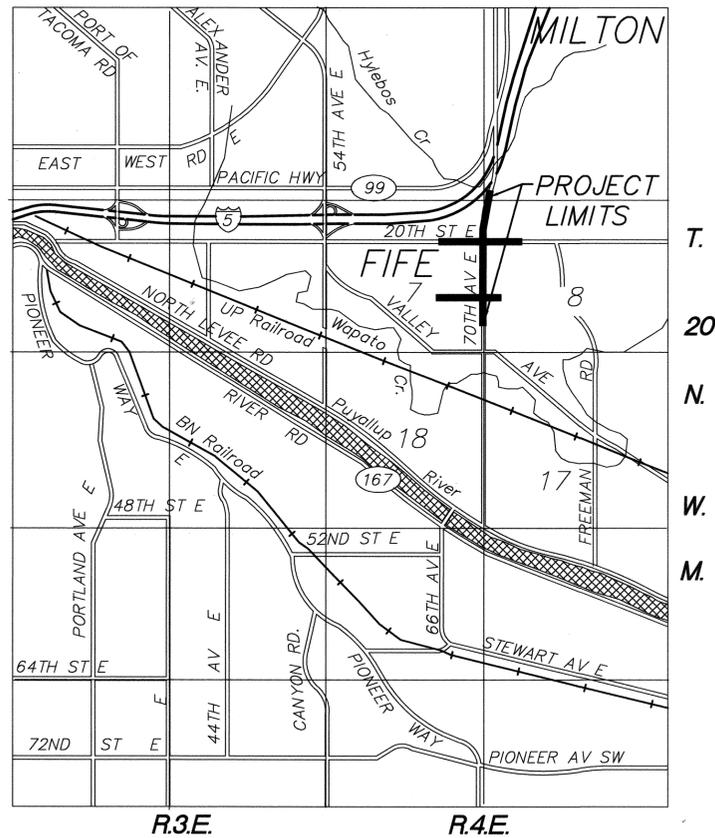

VICINITY MAP
NOT TO SCALE

CITY OF FIFE
CITY COUNCIL:

Richard Godwin
Tim Curtis
Glenn Hull
Pat Hulcey
Rob Cerqui, Mayor
Dierdre Dukes-Gethers
Lew Wolfrom

CITY MANAGER:

Dave Zabell

CITY ENGINEER:


Russ Blount, P.E.



APPROVED FOR CONSTRUCTION _____ DATE _____
CITY OF FIFE PUBLIC WORKS DIRECTOR

RECORD DRAWING

PROJECT ENGINEER: A. TEBALDI			
DESIGNED BY: A. TEBALDI, G. NELSON			
DRAWN BY: S. HICKS, J. KIRKMAN, B. MORRIS			
CHECKED BY: L. ONORATI, M. CLARK			
DATE PLOTTED: JULY 2012			
FILE: TTCV001FIFE000165.DWG	DATE	REVISIONS	APPRVD.

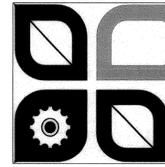City of Fife
Department of Public Works
5411-23rd Street East
Fife, Washington 98424

PLANS PREPARED BY:



DAVID EVANS AND ASSOCIATES INC.
3700 Pacific Hwy. East, Suite 311
Fife, Washington 98424
Phone: 253.922.9780

CITY OF FIFE
70TH AVENUE EAST - PHASE 2

COVER SHEET

SHEET G-1
1 OF 192

K:\07\2014\11-400m - P:\FIFE\00000165\0400CAD\TTCV\RECORD DRAWINGS\01 General\TTCV001FIFE000165.dwg