70TH AVENUE EAST IMPROVEMENTS

A PORTION OF THE NE 1/4 OF THE SE 1/4 OF SECTION 18, TOWNSHIP 20 N., RANGE 4 E., WILLAMETTE MERIDIAN

CITY of FIFE, PIERCE COUNTY, WASHINGTON

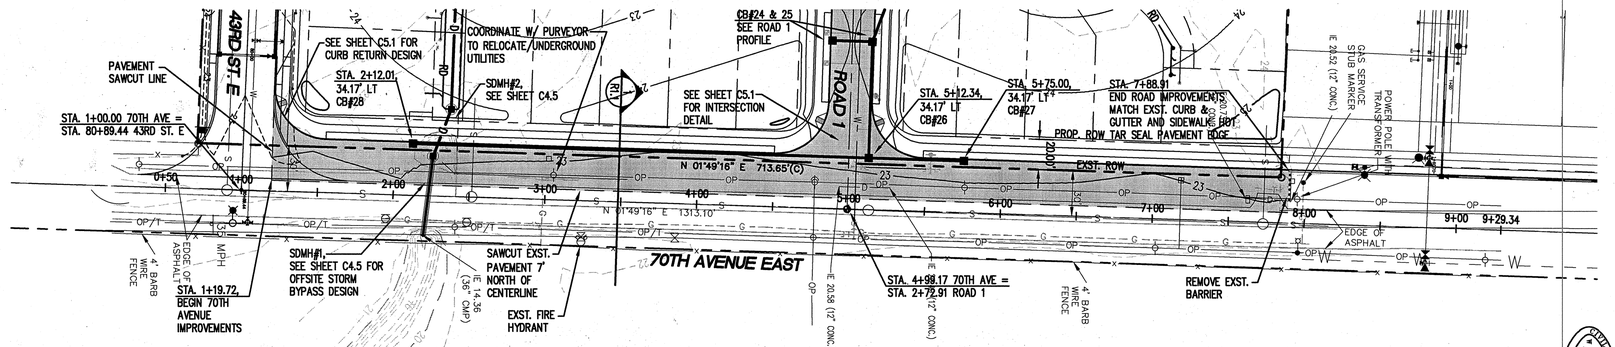

70TH AVENUE EAST PLAN

HORIZONTAL: 1"=50'

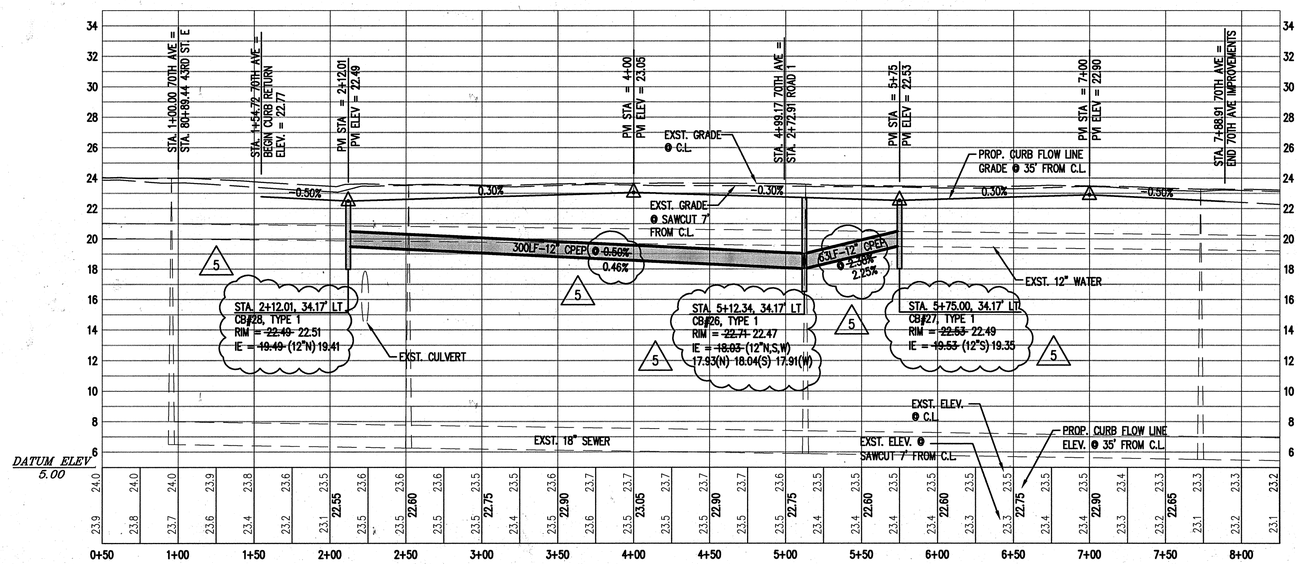

70TH AVENUE EAST PROFILE

VERTICAL: 1"=5'
HORIZONTAL: 1"=50'

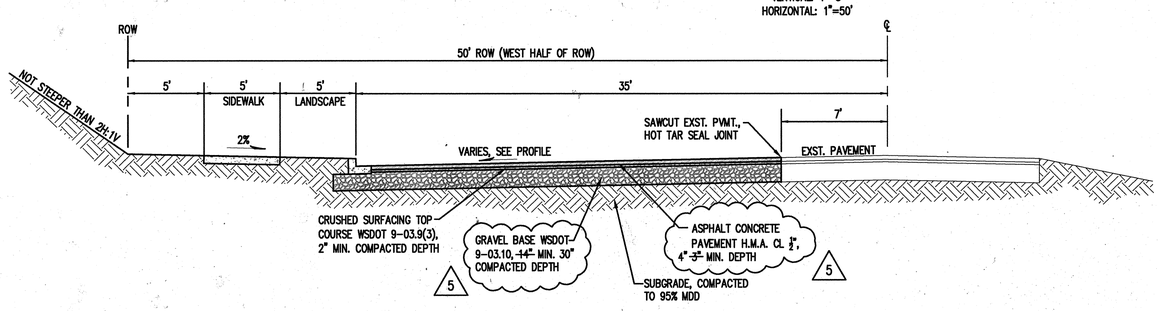

1 70TH AVENUE EAST SECTION (STA. 1+19.72 - STA. 7+88.91)

NOT TO SCALE

CALL 48 HOURS BEFORE YOU DIG 1-800-424-5555

GRAPHIC SCALE

50 0 25 50 100 200

(IN FEET)
1 inch = 50 ft.

BENCHMARK

2003 CITY OF FIFE VERTICAL BENCHMARK
FS-32 PIERCE COUNTY BRASSIE IN ISLAND 35 FEET EAST OF CENTERLINE OF 70TH AVENUE EAST AND 20 FEET NORTH OF CENTERLINE OF NORTH LEVEE ROAD
ELEV=31.23'(NGVD29)

PLAN ELEVATION 100.00' = CITY OF FIFE DATUM 99.55'

RECORD NOTE

THESE RECORD DRAWINGS HAVE BEEN PREPARED BASED ON INFORMATION SUBMITTED, IN PART, BY OTHERS. WHILE THIS INFORMATION IS BELIEVED TO BE RELIABLE, AHBL IS NOT RESPONSIBLE FOR ITS ACCURACY, OR ERROR OR OMISSIONS WHICH MAY HAVE BEEN INCORPORATED INTO THIS DOCUMENT AS A RESULT. THOSE RELYING ON THIS RECORD DOCUMENT ARE ADVISED TO OBTAIN INDEPENDENT VERIFICATION OF ITS ACCURACY BEFORE APPLYING IT FOR ANY PURPOSE.

I. MATTHEW WEBER, STATE OF WASHINGTON, 34858, REGISTERED PROFESSIONAL ENGINEER, 12/19/06
EXPIRES 11/07/08

Civil Engineers
Structural Engineers
Landscape Architects
Community Planners
Land Surveyors
Neighbors

AHBL
TACOMA · SEATTLE
2215 North 30th Street, Suite 300, Tacoma, WA 98403
253.383.2422 TEL
316 Occidental Avenue South, Suite 320, Seattle, WA 98104
206.267.2425 TEL

Project Title:
70TH AVENUE EAST IMPROVEMENTS

Client:
CAPSTONE HOMES, INC.
P.O. BOX 138
MAPLE VALLEY, WA 98038
TAIJI MIYAMOTO
(425) 432-3122

Job No.
204137.10

Issue Set & Date:
AS-BUILT SET
07/12/06

I. MATTHEW WEBER, STATE OF WASHINGTON, 34858, REGISTERED PROFESSIONAL ENGINEER, 12/19/06
EXPIRES 11/07/08

REUSE OF DOCUMENTS
THIS DOCUMENT HAS BEEN SIGNED ELECTRONICALLY IN ACCORDANCE WITH WAC 196-23-070 AND CHAPTER 19.34 RCW. UNAUTHORIZED ALTERATION OF ANY OF THE INFORMATION ON THIS DOCUMENT WILL INVALIDATE THE DOCUMENT, AT CERTIFICATION AND SIGNATURE.
THE IDEAS AND DESIGNS INCORPORATED HEREIN, AS AN INSTRUMENT OF PROFESSIONAL SERVICE, ARE THE PROPERTY OF AHBL AND IS NOT TO BE USED, IN WHOLE OR IN PART, FOR ANY OTHER PROJECT WITHOUT WRITTEN AUTHORIZATION OF AHBL.

5 AS-BUILTS 07/12/06 MW
4
3
2
1

Revisions:

Sheet Title:
70TH AVENUE EAST PLAN & PROFILE

Designed by:	Drawn by:	Checked by:
GCH	GCH	SMC

Sheet No.
R1.1
22 of 23 Sheets